


Ties-2A<sup>3</sup>Cmp. Replacement  
Intersection Center of Catalina.

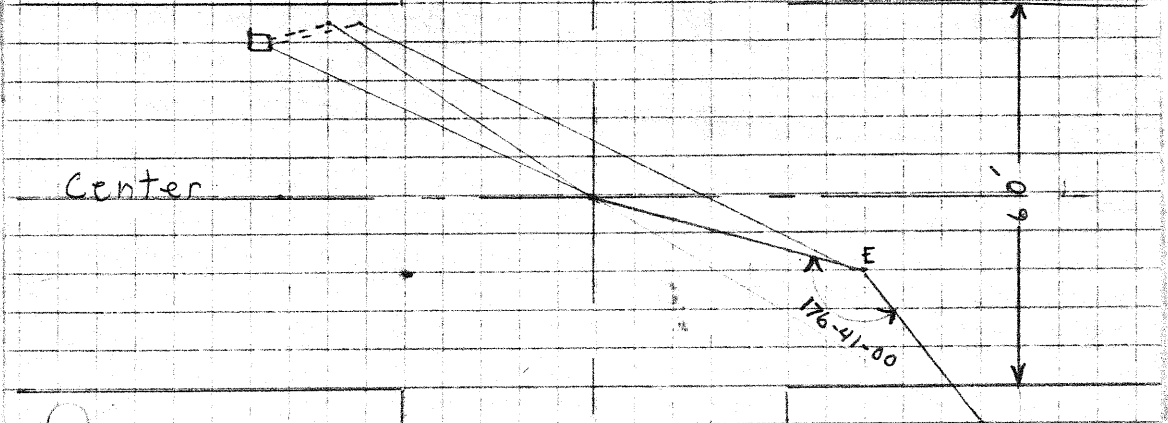

- ∠ OAB = 19-15-20
- ∠ OAC = 31-37-00
- ∠ OAD = 33-53-40
- ∠ OAE = 79-02-00

Note!  
As built ∠ OAE = 195-16-20  
dist AE = 42.40'

- Elev B (E) = 132.69
- C (E) = 127.97
- D (E) = 126.88
- E (E) = 118.67

- Dist AB = 59.60'
- AC = 51.40
- AD = 49.40
- AE = 32.71

← 50' →

Catalina St