


NOTE:  
 8" V.C.P. SEWER MAIN IN PARK AVE RELAID WITH  
 8" V.C.P. FROM GOFF ST TO THROUGH ST.  
 NEW LINE INFO PLOTTED IN ORANGE COLOR.  
 "AS BUILT" NOTES - K-1-14 A

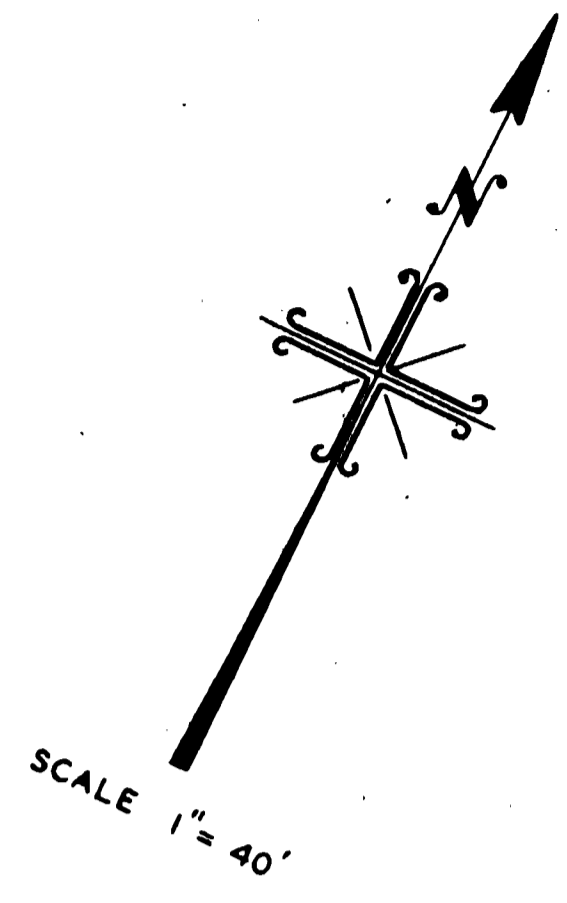

ADJOINING MAP NO. 56

ADJOINING MAP NO. 58

ADJOINING MAP NO. 49

ADJOINING MAP NO. 54

REVISIONS				
DATE	DESCRIPTION	BY	CHECKED	APPROVED

CITY OF LAGUNA BEACH, CALIFORNIA  
 DEPARTMENT OF PUBLIC WORKS - ENGINEERING DIVISION  
 CRAIG G. LELAND - CITY ENGINEER  
**DISTRICT MAP**  
 SEWER