


I R V I N E ' S   S U B D I V I S I O N

183

M.M. 1-88

O R A N G E   C O U N T Y

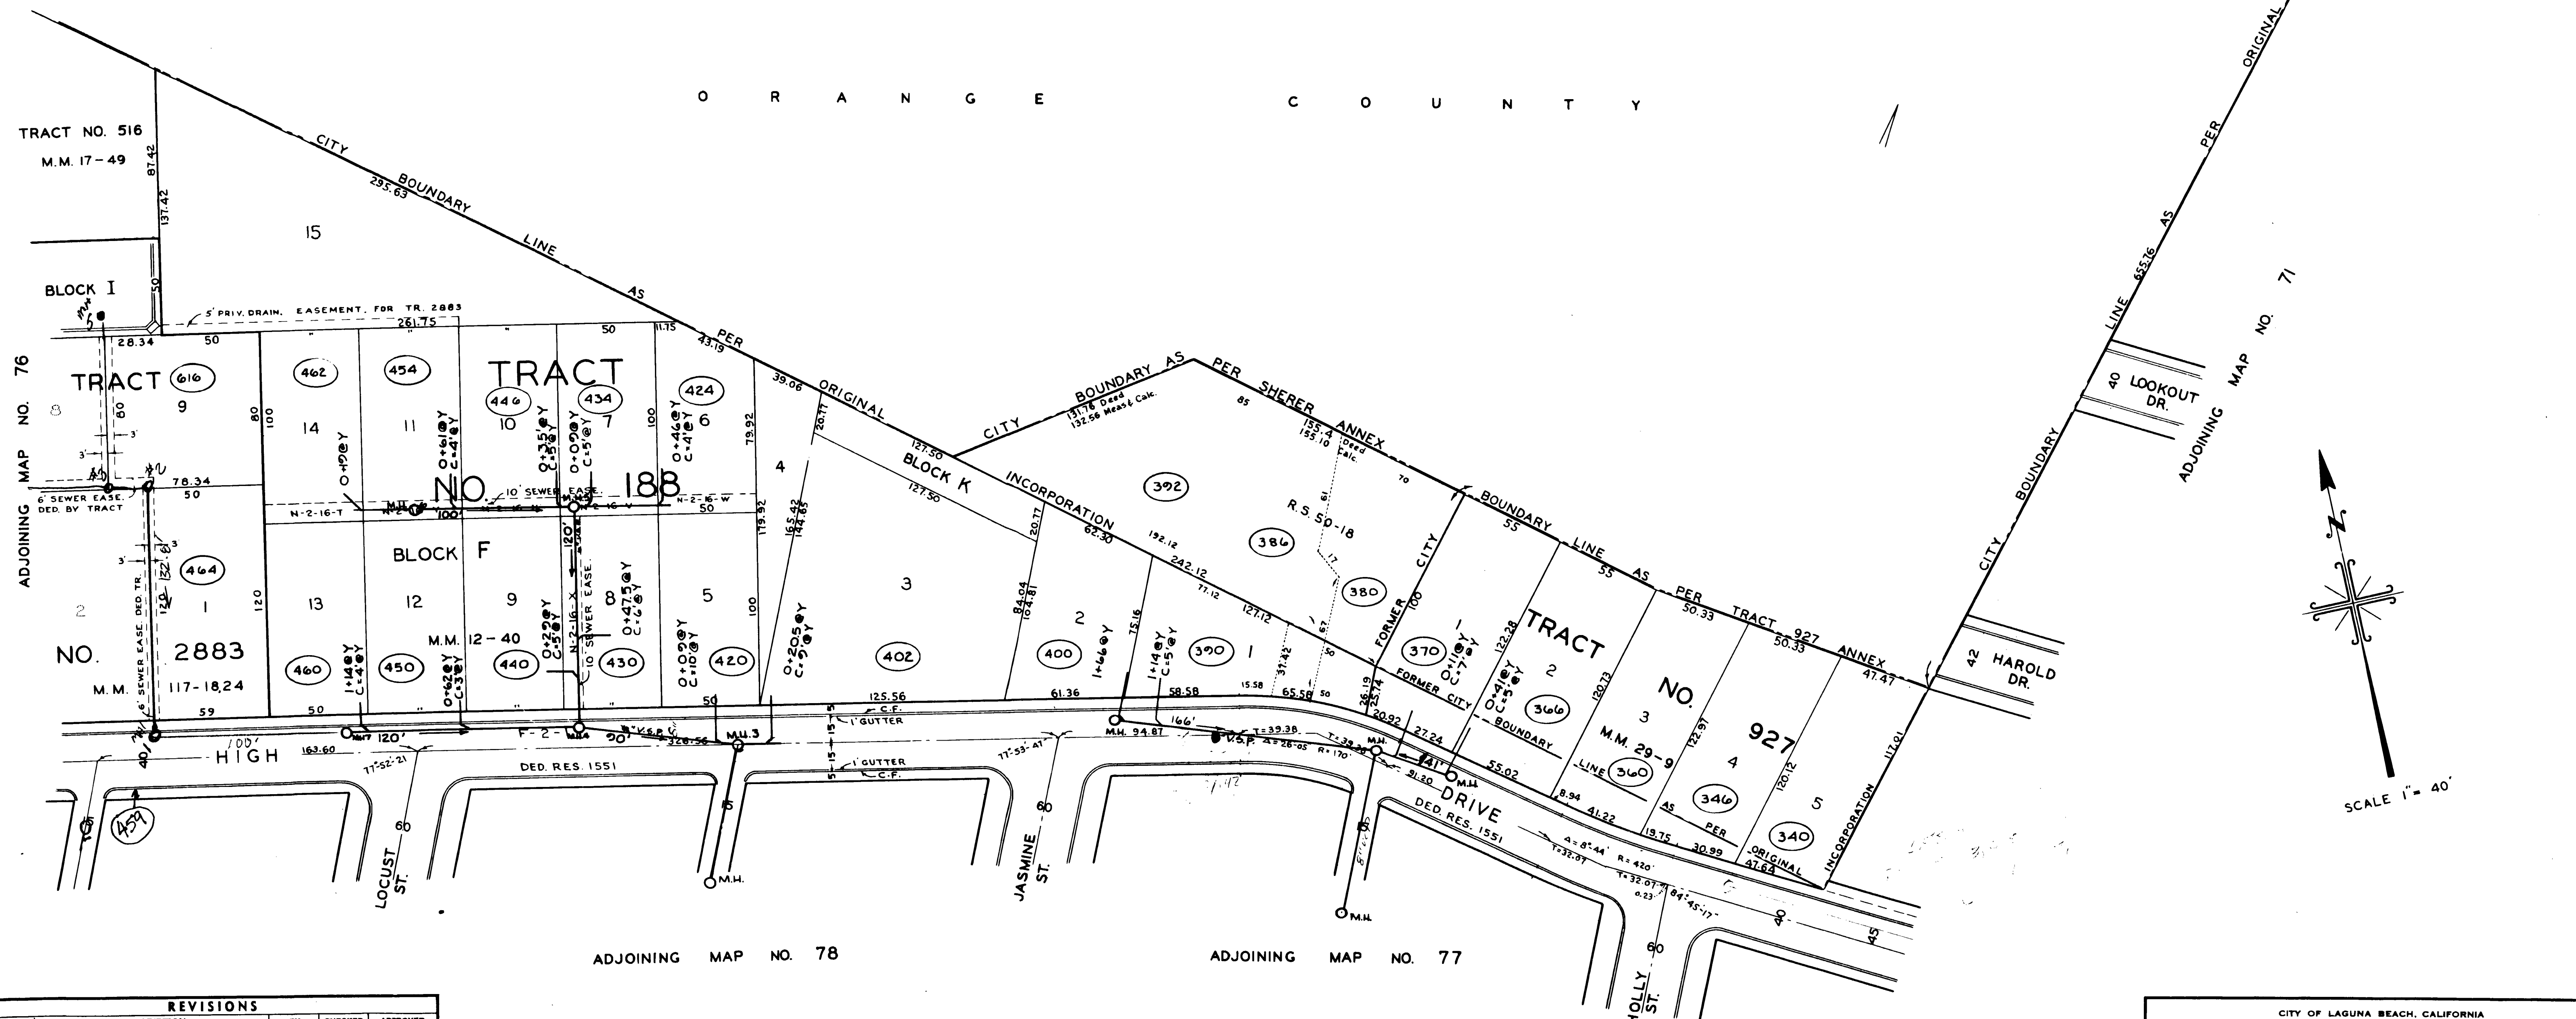

ADJOINING MAP NO. 72

ADJOINING MAP NO. 71

ADJOINING MAP NO. 76

ADJOINING MAP NO. 78

ADJOINING MAP NO. 77

REVISIONS				
DATE	DESCRIPTION	BY	CHECKED	APPROVED
9-26-61	ADDED TR. NO. 2883	LCB		
11/1/67	SEWER COPIED FROM AS-BUILT	SLS		

APPROVED OCT. 30-'58 DATE

CITY OF LAGUNA BEACH, CALIFORNIA  
 DEPARTMENT OF PUBLIC WORKS—ENGINEERING DIVISION  
 PAUL V. HENNESSY—CITY ENGINEER

**DISTRICT MAP**

DRAWN BY V. AZNAK	CHECKED BY D. H. PAUL	SUPERVISED BY D. H. PAUL	DRAWING AND FILE NO. 75
----------------------	--------------------------	-----------------------------	----------------------------